



1 SITE SECTION
EAST WEST AXIS - BINALONG ROAD
SCALE: 1:200

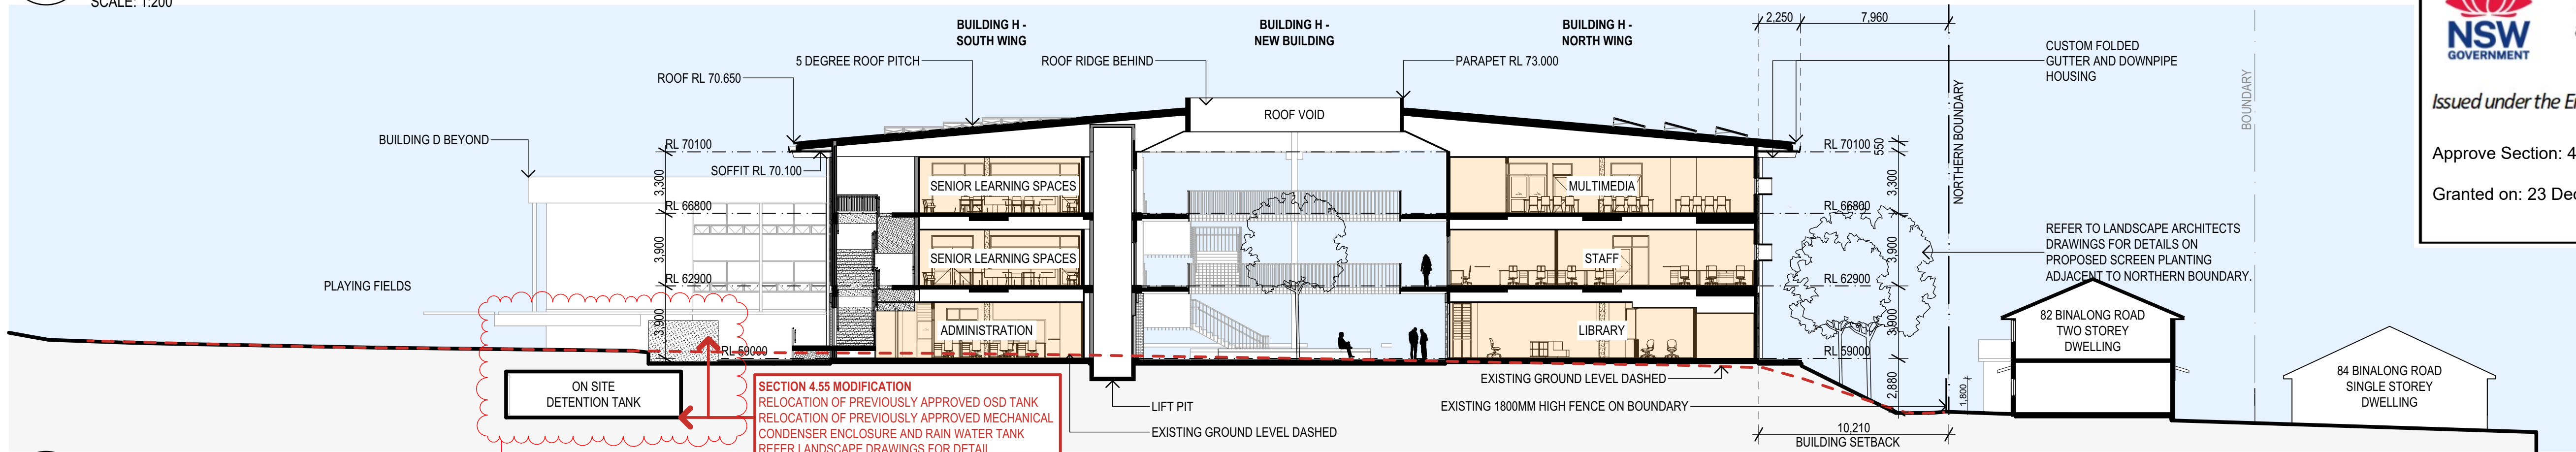

2 SITE SECTION
NORTH SOUTH - THROUGH BUILDING H
SCALE: 1:200

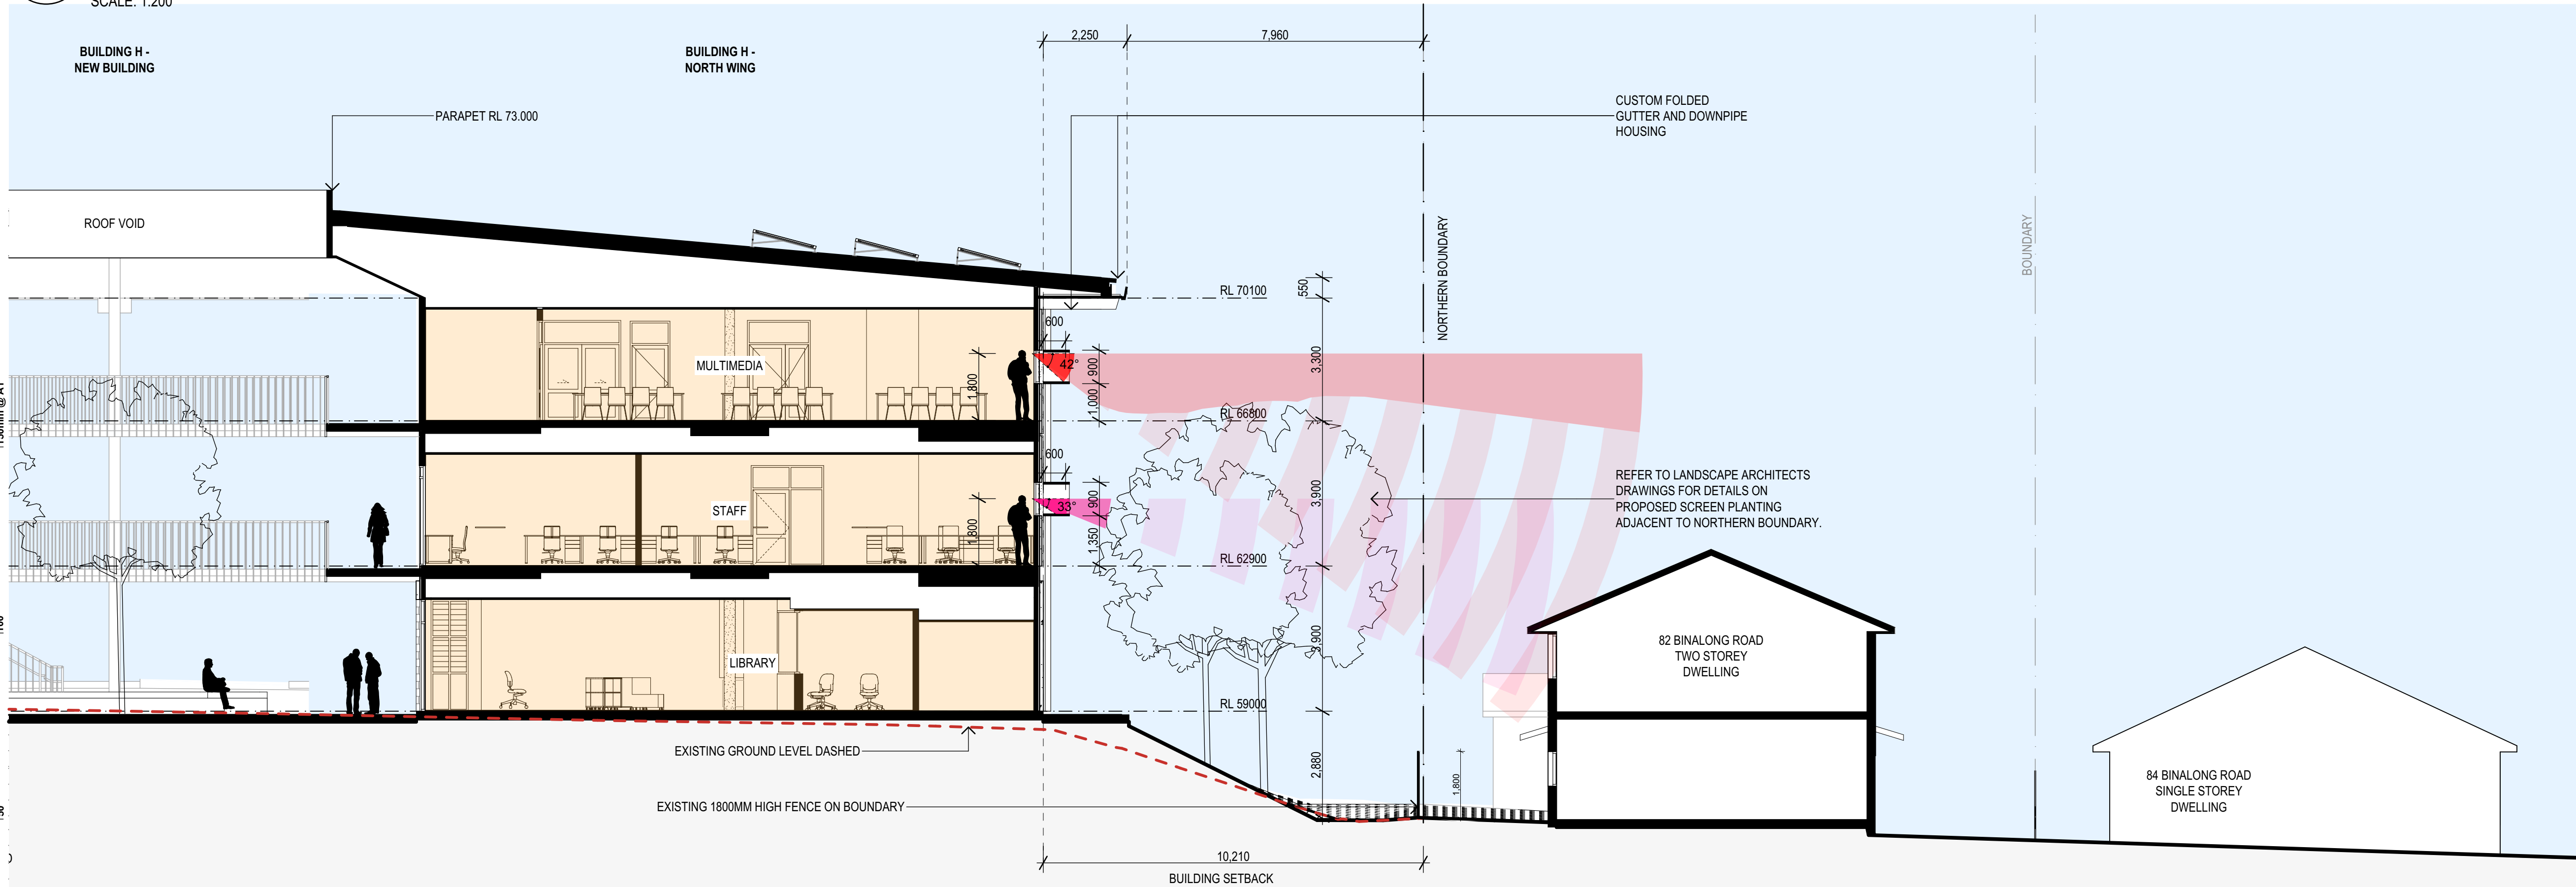

3 SITE SECTION
NORTH SOUTH - THROUGH NEIGHBOURING PROPERTY
SCALE: 1:100

Copyright
This drawing shows design features and elements of a design prepared by
Fulton Trotter Architects and is to be used only for work authorised in
writing by the designers. It cannot be copied directly or indirectly, in whole
or in part, nor shall it be used for any other building purposes. Unauthorised
use will be considered an infringement of these rights.



Department of Planning
and Environment

Issued under the Environmental Planning and Assessment Act 1979

Approve Section: 4.55(1A) Application No: SSD-9579147-Mod-1

Granted on: 23 December 2022 Sheet no: 2 of 8 Signed: TVD

REV.	DESCRIPTION	DATE	INIT.
A	ISSUED FOR SSDA	04/05/2021	AP
B	SECTION 4.55 MODIFICATION ISSUE UPDATE	26/09/2022	AK

fulton trotter
ARCHITECTS

SYDNEY
BRISBANE
SYDNEY

Level 3, 35 Spring Street
PO Box 1669
Bondi Junction, NSW 2022
t: (02) 8383 5151
e: sydney@fultontrotter.com.au
DIRECTORS
Greg Isaac raia NSW 6855 QLD 2020
Justine Ezoray raia QLD 3313
John Ward raia VIC 18804 NSW 8371 QLD 3847
Katerina Dracopoulos raia QLD 4529
Mark Trotter raia VIC 17691 NSW 4421 QLD 1870
Paul Sekava raia NSW 7180 QLD 3108
Paul Trotter raia NSW 7177 QLD 2948
Ryan Loveday raia QLD 4500

www.fultontrotter.com.au

**STATE SIGNIFICANT
DEVELOPMENT APPLICATION**

SCHOOL INFRASTRUCTURE NSW

PENDLE HILL HIGH SCHOOL

19-21 CORNOCK AVENUE
PENDLE HILL, NSW, 2146

SITE SECTIONS

Figured dimensions take precedence over
scale dimensions. Contractors must verify
all dimensions on site before commencing
any work or making shop drawings.

PROJECT NUMBER
7068TO01

DIRECTOR
JW

CHECKED

DRAWING NUMBER
ACD-1007

REVISION
B



Department of Planning
and Environment

Issued under the Environmental Planning and Assessment Act 1979

Approve Section: 4.55(1A) Application No: SSD-9579147-Mod-1

Granted on: 23 December 2022 Sheet no: 3 of 8 Signed: TVD

BUILDING E
GROUND RL 59.79
LEVEL ONE RL 62.90

BUILDING H - NORTH
GROUND RL 59.00
LEVEL ONE RL 62.90
LEVEL TWO RL 66.80

FOR DETAILS ON SLAB SETOUT
REFER CONCRETE OUTLINE DRAWINGS
A-BLK-H-2301

BUILDING H - SOUTH
GROUND RL 59.00
LEVEL ONE RL 62.90
LEVEL TWO RL 66.80

BUILDING D
GROUND RL 61.56
LEVEL ONE RL 64.64

1 PLAN
EXTERNAL WORKS SITE PLAN 01
SCALE: 1:200

plot date: Monday, 7 November 2022, 2:51 PM

file location: S:\7068 D01\7068T001 Pendle Hill High School\SIGN OFF (PDF)s\Archive in IRIS\26. SSDA MOD 4.55\7068T001 - PHHS - SITE - EXTERNAL WORKS DRAWING - SECTION 4.55 MOD - 29-08-2022.ph

Copyright

This drawing shows design features and elements of a design prepared by
Fulton Trotter Architects and is to be used only for work authorised in
writing by the designers. It cannot be copied directly or indirectly, in whole
or in part, nor shall it be used for any other building purposes. Unauthorised
use will be considered an infringement of these rights.

PROPOSED SITE PLAN LEGEND

- EXTENT OF PROPOSED WORKS
- EXISTING BUILDINGS
- PROPOSED BUILDINGS
- WORKS UNDER OTHER APPROVALS
(CDC / EXEMPT DEVELOPMENT)
- EXISTING PAVING
- PROPOSED PAVING
- EXISTING ASPHALT
- PROPOSED ASPHALT
- EXISTING LANDSCAPING
- PROPOSED LANDSCAPING
- EXISTING FENCING
- PROPOSED FENCING
- EXISTING TREES
- PROPOSED TREES
- EXISTING SPOT LEVEL
- PROPOSED SPOT LEVEL
- PROPOSED SITE CONTOURS (500MM)
- SRZ - STRUCTURAL ROOT ZONE
- TPZ - TREE PROTECTION ZONE

NOTES

REFER TO LANDSCAPE ARCHITECTS DRAWINGS FOR
DETAILS ON PROPOSED TREES AND SITE PLANTING.
LANDSCAPE DRAWINGS INCLUDE RELEVANT
INFORMATION IN REGARDS TO NUMBER AND SPECIES
OF PROPOSED PLANTING AND HEIGHTS OF TREES AT
MATURITY. PROPOSED CANOPY COVERAGE CAN BE
FOUND ON LANDSCAPE ARCHITECTS DRAWINGS.

ALL EXISTING TREES THAT ARE TO BE RETAINED
WITHIN SSDA WORKS ZONE TO HAVE TRUNK BRANCH
WRAPPING AND SOIL PROTECTION TO ARBORIST
SPECIFICATION.

MINIMUM RAMP GRADIENT 1:15 WITH HANDRAILS AND
BALUSTRADES TO COMPLY WITH EFSG

REV.	DESCRIPTION	DATE	INIT.
C1	CONSTRUCTION ISSUE	10/01/2022	AP
C2	REVISED CONSTRUCTION ISSUE	12/05/2022	AP
C3	SECTION 4.55 MODIFICATION ISSUE	07/11/2022	AP

fulton trotter
ARCHITECTS

SYDNEY
Level 3, 35 Spring Street
PO Box 1669
Bondi Junction, NSW 2022

DIRECTORS
Greg Isaac raia
Justine Eboray raia
John Ward raia
Katerina Dracopoulos raia
Mark Trotter raia
Paul Sekava raia
Paul Trotter raia
Ryan Loveday raia

www.fultontrtrotter.com.au

CONSTRUCTION

SCHOOL INFRASTRUCTURE NSW

PENDLE HILL HIGH SCHOOL

66 BINALONG ROAD
PENDLE HILL, NSW, 2146

EXTERNAL WORKS PLAN 01

Figured dimensions take precedence over
scale dimensions. Contractors must verify
all dimensions on site before commencing
any work or making shop drawings.

PROJECT NUMBER
7107T001

DRAWING NUMBER
A-EXT-1201

DIRECTOR
JW

CHECKED
C3

BINALONG ROAD

MW151 - PROPOSED 2100 HIGH
SECURE LINE FENCING TO BOUNDARY
TO MATCH EXISTING.
ALIGN MINIMUM 1000MM FROM SUBSTATION KIOSK.

- PROPOSED PAD MOUNT SUBSTATION (MIN. 5500MM X 2750MM)
- PROVIDE 150MM HIGH CONCRETE HOB AROUND PERIMETER OF SUBSTATION
(REFER CIVIL ENGINEERS DETAILS)
- PROVIDE 2100MM HIGH NON-COMBUSTIBLE STEEL FENCING FIXED TO TOP OF
CONCRETE HOB.
- NO COMBUSTIBLE MATERIALS TO BE LOCATED WITHIN THE SUBSTATION
CLEARANCE ZONE DENOTED IN RED, MEASURED 3M (HORIZONTALLY) AND 6M
VERTICALLY FROM THE SUBSTATION HOUSING

MW151 - PROPOSED 2100 HIGH
SECURE LINE FENCING TO BOUNDARY
TO MATCH EXISTING

1000MM HIGH BALUSTRADE ABOVE (MW001)

INSITU CONCRETE RAMPS (CC01-CC01) - MINIMUM 1:15
1600MM CLEAR WIDTH WITH 150MM HIGH CONCRETE HOB TO BOTH SIDES
MW001 / MW050 - GALVANISED HANDRAIL AND BALUSTRADES TO EFSG
REQUIREMENTS. 1000MM HIGH BALUSTRADE WITH
DOUBLE HANDRAILS AT 865MM & 700MM
RETAINING WALLS (MA51-BL01)

2400 HIGH INSITU CONCRETE WALL (CC01-CC01)
2100 HIGH SLIDING GATE HOUSED BEHIND WALL
SCHOOL SIGNAGE FIXED TO CONCRETE WALL
(REFER SIGNAGE SCHEDULE)

PROPOSED MAIN PEDESTRIAN ENTRY /
FORECOURT

900-950MM HIGH RETAINING WALL (MA51-BL01) TO SOUTHERN SIDE
OF STAIR TO MINIMISE IMPACT ON EXISTING TREES

FIRE BOOSTER ENCLOSURE
TO FIRE ENGINEERS
REQUIREMENTS

HYDRANT PUMP ENCLOSURE
TO HYDRAULIC AND FIRE ENGINEERS
REQUIREMENTS

MW151 - PROPOSED 2100 HIGH
SECURE LINE FENCING TO BOUNDARY
TO MATCH EXISTING.
PROVIDE MINIMUM 1000MM FROM FIRE SERVICES.

PROPOSED FOOT PATH WIDENING
TO KISS AND DROP / BUS BAY

MW151 - PROPOSED 2100 HIGH
SECURE LINE FENCING TO BOUNDARY
TO MATCH EXISTING

SITE WORKS - MATERIALS LEGEND

CO01 - CONCRETE - INSITU NATURAL GREY
CO03 - CONCRETE - PRECAST NATURAL GREY
CO04 - CONCRETE - PRECAST RIBBED PROFILE
CO05 - CONCRETE POST TENSIONED - NATURAL GREY
CO15 - CONCRETE JOINT - EXPANSION
MA01 - BRICKS - FACEWORK - TYPE 1
MA40 - BLOCKWORK - 150 SERIES - STANDARD
MA50 - BLOCKWORK - 200 SERIES - STANDARD
MA51 - BLOCKWORK - 200 SERIES - COLOURED / SMOOTH
MW050 - HANDRAIL - STEEL
MW150 - GATE - STEEL
MW151 - SECURE LINE FENCING TO BOUNDARY
MW160 - INTERNAL SECURE LINE FENCING
MW360 - BIKE RACKS
MW400 - TGS1 - WARNING STAINLESS STEEL
MW451 - STAIR NOSINGS - CONCRETE AND VINYL

SITE WORKS - FINISHES LEGEND

BK01 - BOWRAL 76 / CHILLINGHAM WHITE
BL01 - BORAL / ALMOND / SMOOTH FACE
CO01 - NATURAL GREY
CO02 - PRECAST SMOOTH FINISH
CO03 - PRECAST RIBBED FINISH
MF02 - HDG STEEL

SECTION 4.55 MODIFICATION
RELOCATION OF PREVIOUSLY APPROVED OSD TANK
RELOCATION OF PREVIOUSLY APPROVED MECHANICAL
CONDENSER ENCLOSURE AND RAIN WATER TANK
REFER LANDSCAPE DRAWINGS FOR DETAIL

SECTION 4.55 MODIFICATION
PREVIOUSLY APPROVED MECHANICAL
CONDENSER ENCLOSURE AND ASSOCIATED
ACCESS STAIR DELETED FROM PROJECT
REINSTATE WITH LANDSCAPING
AS PER LANDSCAPE ARCHITECTS DRAWINGS

EXISTING BRICK RETAINING WALLS
WITH FENCING ABOVE

PROPOSED 2100 HIGH FENCING
TO MATCH EXISTING

82 BINALONG ROAD
TWO STOREY DWELLING

DASHED LINES DENOTE STRUCTURAL
BEAMS ABOVE

STEEL COLUMNS SUPPORTING
COVERED ROOF

COVERED WALKWAY ROOF ABOVE

EGRESS PATH

EGRESS PATH


EGRESS PATH

EGRESS PATH
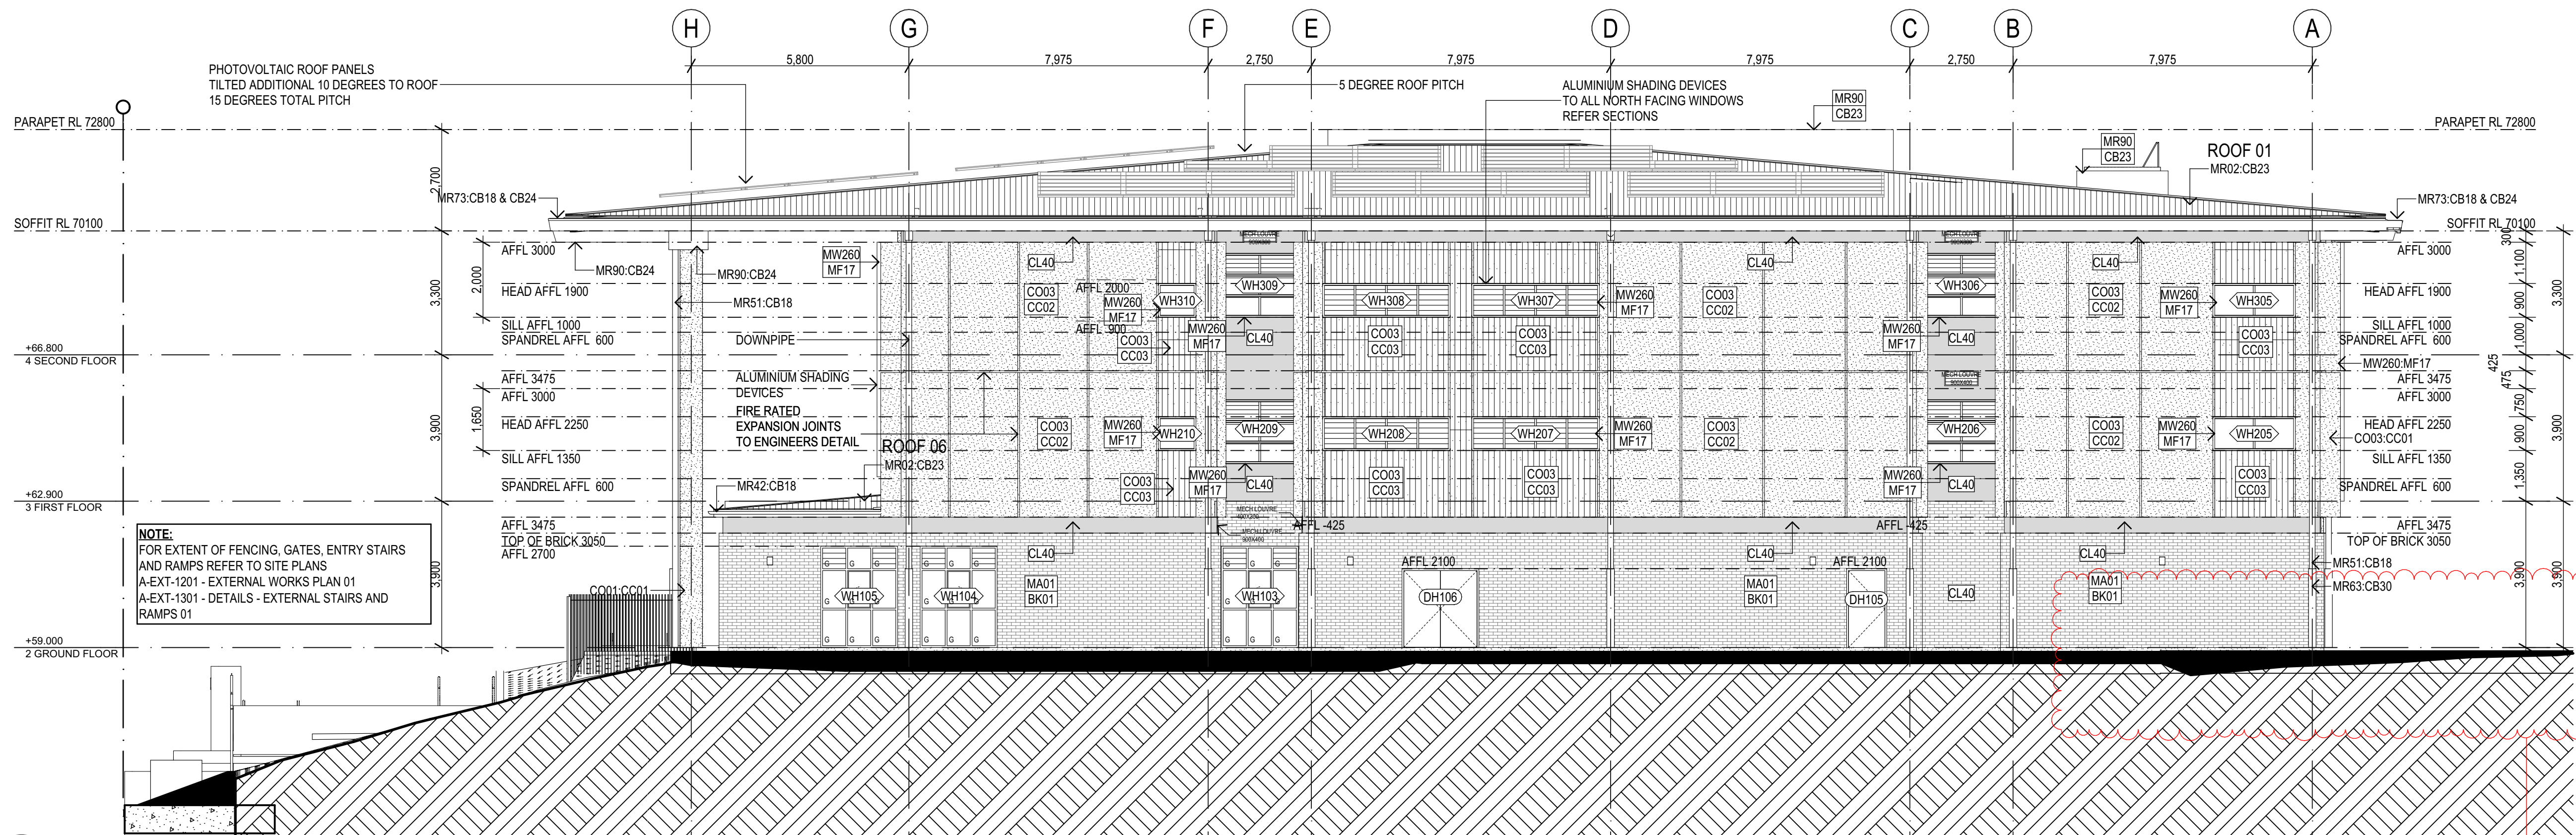

1 ELEVATION
ELEVATION NORTH
SCALE: 1:100

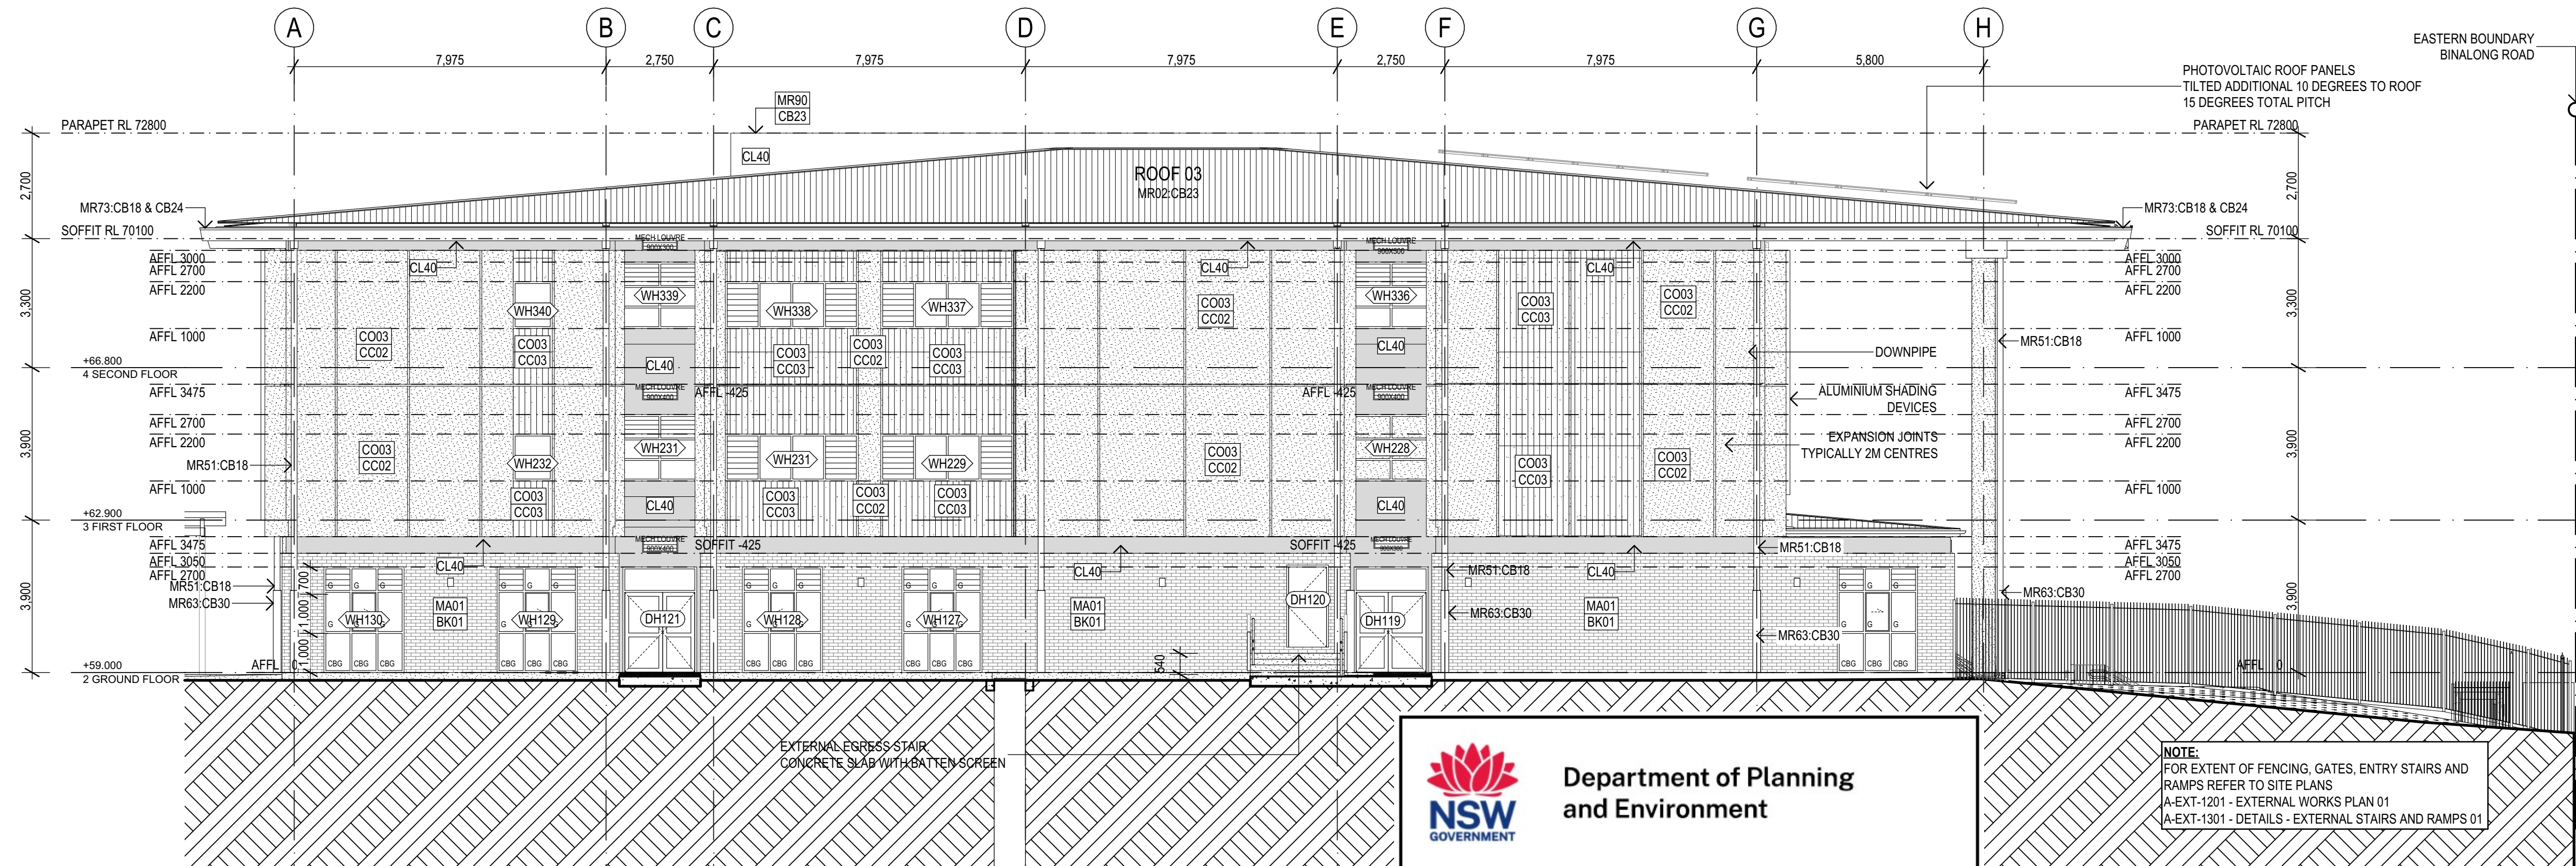

2 ELEVATION
ELEVATION SOUTH
SCALE: 1:100

ELEVATION LEGEND	
	DOOR LABEL
	WINDOW LABEL
	MATERIAL CODE (REFER TO MATERIAL LEGEND)
	WALL MATERIAL / FINISH LABEL
	FINISH CODE (REFER TO FINISHES LEGEND)

ELEVATION MATERIAL LEGEND

CL40 - PREFINISHED SHEETS - CFC TYPE 1
CL41 - PREFINISHED SHEETS - CFC TYPE 2
CO01 - CONCRETE - INSITU NATURAL GREY
CO03 - CONCRETE - PRECAST NATURAL GREY
IS46 - INSULATION - PROJECT SPECIFIC TYPE 1
LC04 - PLASTERBOARD - 13MM MOISTURE RESISTANT
LC09 - PLASTERBOARD - 13MM IMPACT RESISTANT
MA01 - BRICKS - FACEWORK - TYPE 1
SF01 - STEEL FURRING CHANNEL - TYPE 1 - 35MM
SS01 - STRUCTURAL STEEL - FRAMING

ELEVATION FINISH SCHEDULE

BK01 - BOWRAL 76 / CHILLINGHAM WHITE
CC01 - NATURAL GREY
CC02 - PRECAST SMOOTH FINISH
CC03 - PRECAST RIBBED FINISH
CL40 - PANELCORP CERAMAPANEL / RAW / CPR7012
CL41 - PANELCORP CERAMAPANEL / DEPTH / CPD7043
PF01 - DULUX - LEXICON / PN2F1

ROOF MATERIAL LEGEND

MR02 - METAL ROOF SHEETING - RIBBED
MR42 - GUTTER - 150MM HALF ROUND
MR51 - DOWNPIPE - 150MM DIA
MR63 - DP PROTECTION - PROJECT SPECIFIC TYPE 1
MR73 - FASCIA - METAL FACED CFC
MR90 - FLASHINGS & TRIMS

ROOF FINISHES LEGEND

SK01 - WHITE
CB18 - COLORBOND MONUMENT
CB23 - COLORBOND SHALE GREY
CB23 - COLORBOND SHALE GREY - PAN
CB24 - COLORBOND SURFMIST
CB30 - COLORBOND ZINCALUME

A	ISSUED FOR SSDA	04/05/2021	AP
B	SECTION 4.55 MODIFICATION ISSUE UPDATE	19/09/2022	AK
REV.	DESCRIPTION	DATE	INIT.

fulton trotter
ARCHITECTS

SYDNEY
BRISBANE
SYDNEY

Level 3, 35 Spring Street
PO Box 1669
Bondi Junction, NSW 2022
t: (02) 8383 5151
e: sydney@fultontrotter.com.au

www.fultontrotter.com.au

CONSTRUCTION

SCHOOL INFRASTRUCTURE NSW

PENDLE HILL HIGH SCHOOL

66 BINALONG ROAD
PENDLE HILL, NSW, 2146

ELEVATIONS 01

Figured dimensions take precedence over
scale dimensions. Contractors must verify
all dimensions on site before commencing
any work or making shop drawings.

PROJECT NUMBER
7107T001

DIRECTOR
JW

DRAWING NUMBER
ACD-H-3001

CHECKED
B




Department of Planning
and Environment

Issued under the Environmental Planning and Assessment Act 1979

Approve Section: 4.55(1A) Application No: SSD-9579147-Mod-1

Granted on: 23 December 2022 Sheet no: 4 of 8 Signed: TVD

NOTE:
FOR EXTENT OF FENCING, GATES, ENTRY STAIRS AND
RAMPS REFER TO SITE PLANS
A-EXT-1201 - EXTERNAL WORKS PLAN 01
A-EXT-1301 - DETAILS - EXTERNAL STAIRS AND RAMPS 01

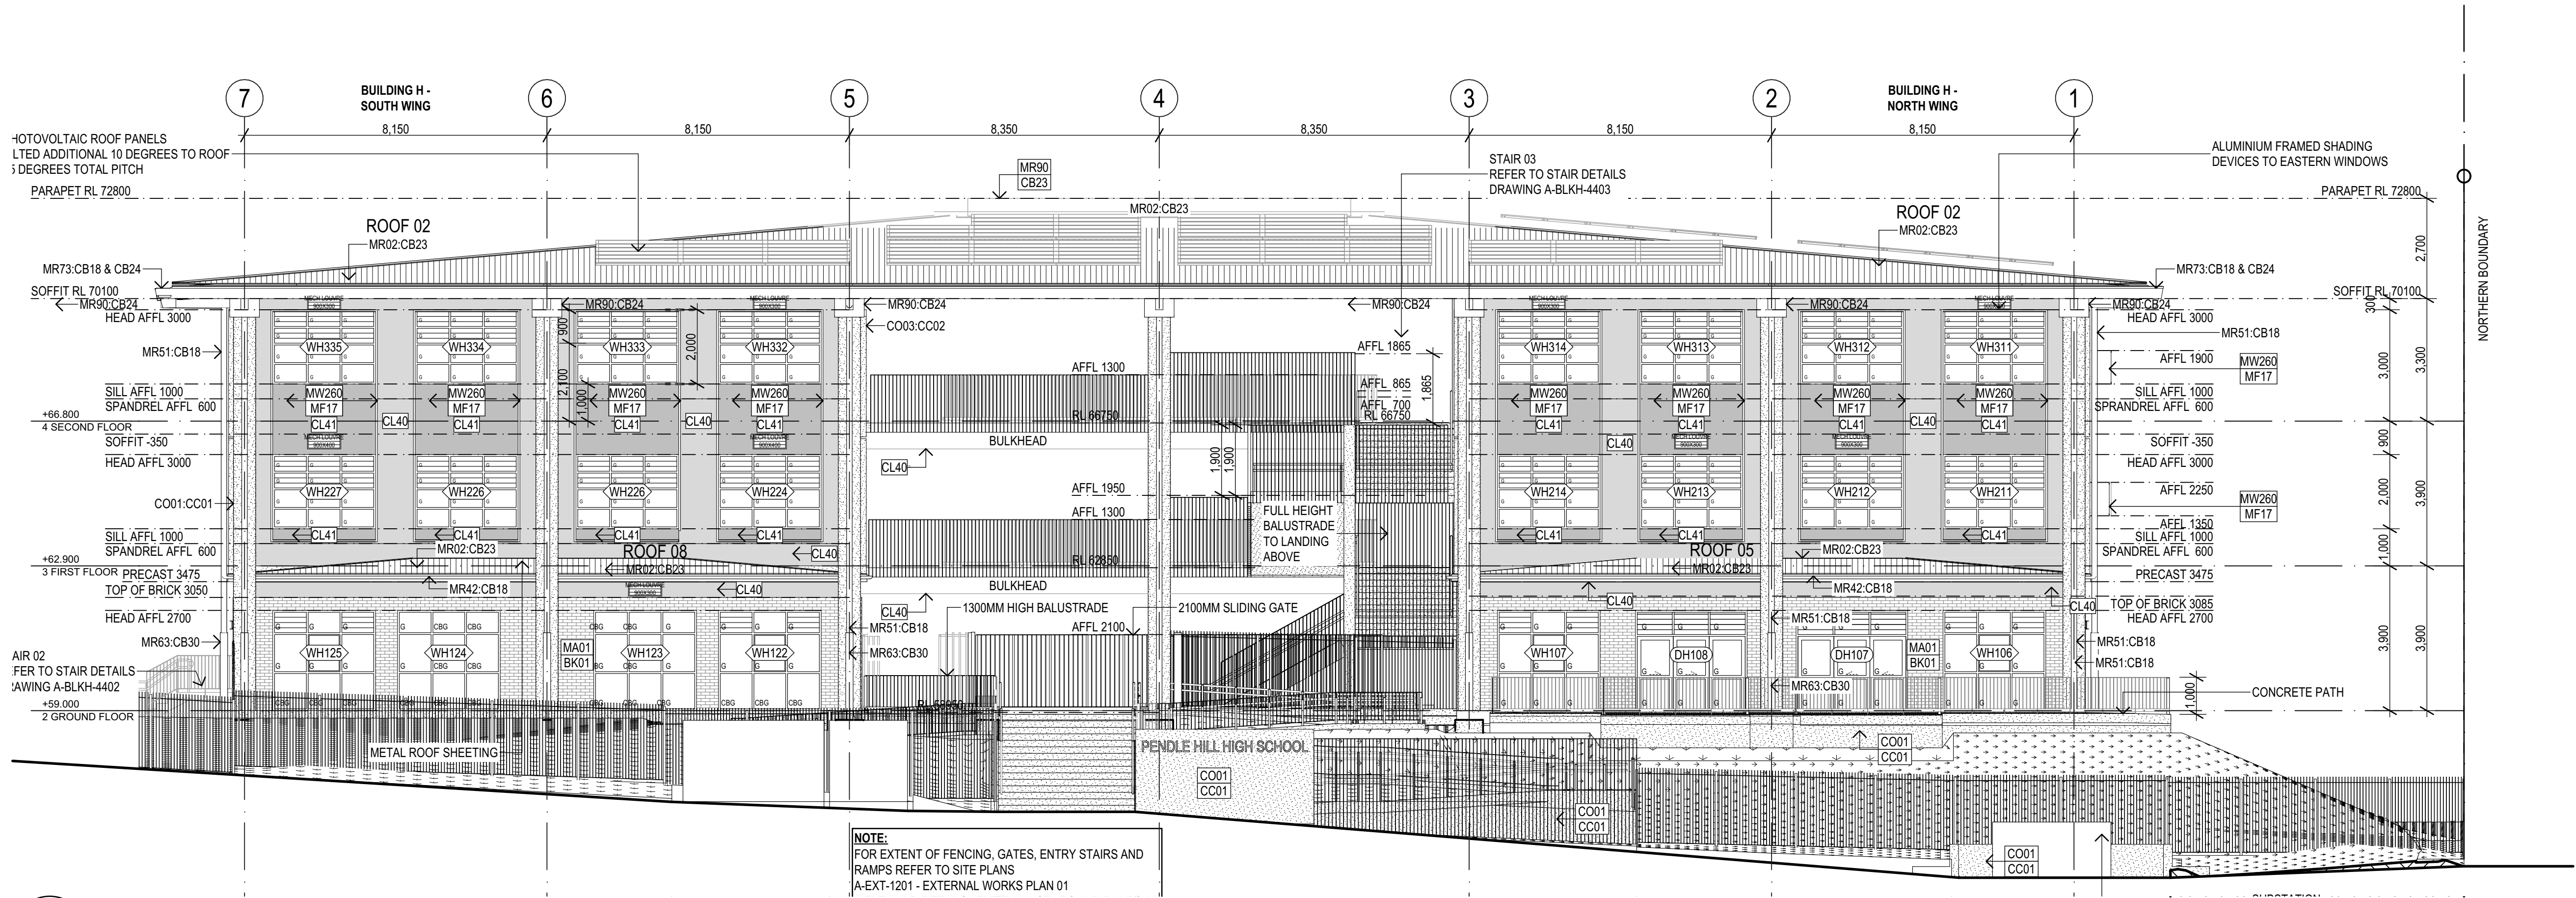

ELEVATION LEGEND

- DOOR LABEL**
D101
- WINDOW LABEL**
W101
- MATERIAL CODE (REFER TO MATERIAL LEGEND)**
XX99
- WALL MATERIAL / FINISH LABEL**
XX99
- FINISH CODE (REFER TO FINISHES LEGEND)**

ELEVATION MATERIAL LEGEND

- CL40 - PREFINISHED SHEETS - CFC TYPE 1
CL41 - PREFINISHED SHEETS - CFC TYPE 2
CO01 - CONCRETE - INSITU NATURAL GREY
CO03 - CONCRETE - PRECAST NATURAL GREY
IS46 - INSULATION - PROJECT SPECIFIC TYPE 1
LC04 - PLASTERBOARD - 13MM MOISTURE RESISTANT
LC09 - PLASTERBOARD - 13MM IMPACT RESISTANT
MA01 - BRICKS - FACEWORK - TYPE 1
SF01 - STEEL FURRING CHANNEL - TYPE 1 - 35MM
SS01 - STRUCTURAL STEEL - FRAMING

ELEVATION FINISH SCHEDULE

- BK01 - BOWRAL 76 / CHILLINGHAM WHITE
CO01 - NATURAL GREY
CO02 - PRECAST SMOOTH FINISH
CO03 - PRECAST RIBBED FINISH
CL40 - PANELCORP CERAMAPANEL / RAW / CPR7012
CL41 - PANELCORP CERAMAPANEL / DEPTH / CPD7043
PF01 - DULUX - LEXICON / PN21

ROOF MATERIAL LEGEND

- MR02 - METAL ROOF SHEETING - RIBBED
MR42 - GUTTER - 150MM HALF ROUND
MR51 - DOWNPIPE - 150MM DIA
MR63 - DP PROTECTION - PROJECT SPECIFIC TYPE 1
MR73 - FASCIA - METAL FACED CFC

ROOF FINISHES LEGEND

- SK01 - WHITE
CB18 - COLORBOND MONUMENT
CB23 - COLORBOND SHALE GREY
CB23 - COLORBOND SHALE GREY - PAN
CB24 - COLORBOND SUBMIT

REV.	DESCRIPTION	DATE	INIT.
A	ISSUED FOR SSDA	04/05/2021	AP
B	SECTION 4.55 MODIFICATION ISSUE UPDATE	19/09/2022	AK

fulton trotter
ARCHITECTS
BRISBANE
SYDNEY

SYDNEY
Level 3, 35 Spring Street
PO Box 1669
Bondi Junction, NSW 2022
t: (02) 8383 5151
e: sydney@fultontrtrotter.com.au

DIRECTORS
Greg Isaac raia
Justine Elzory raia
John Ward raia
Katerina Dracopoulos raia
Mark Trotter raia
Paul Sekava raia
Paul Trotter raia
Ryan Loveday raia

NSW 6855 QLD 2620
NSW 8371 QLD 2313
VIC 18804 NSW 8371 QLD 3847
VIC 17691 NSW 4421 QLD 4529
VIC 17691 NSW 7180 QLD 3108
VIC 17691 NSW 7177 QLD 2948
VIC 17691 NSW 7177 QLD 4500

www.fultontrtrotter.com.au

CONSTRUCTION

SCHOOL INFRASTRUCTURE NSW

PENDLE HILL HIGH SCHOOL

66 BINALONG ROAD
PENDLE HILL, NSW, 2146

ELEVATIONS 02

Figured dimensions take precedence over
scale dimensions. Contractors must verify
all dimensions on site before commencing
any work or making shop drawings.

PROJECT NUMBER
7107T001

DIRECTOR
JW

DRAWING NUMBER
ACD-H-3002

CHECKED
B



Department of Planning
and Environment

Issued under the Environmental Planning and Assessment Act 1979

Approve Section: 4.55(1A) Application No: SSD-9579147-Mod-1

Granted on: 23 December 2022 Sheet no: 5 of 8 Signed: TVD

1 ELEVATION EAST ELEVATION EAST SCALE: 1:100

2 ELEVATION WEST ELEVATION WEST SCALE: 1:100




Department of Planning
and Environment

Issued under the Environmental Planning and Assessment Act 1979

Approve Section: 4.55(1A) Application No: SSD-9579147-Mod-1

Granted on: 23 December 2022 Sheet no: 6 of 8 Signed: TVD

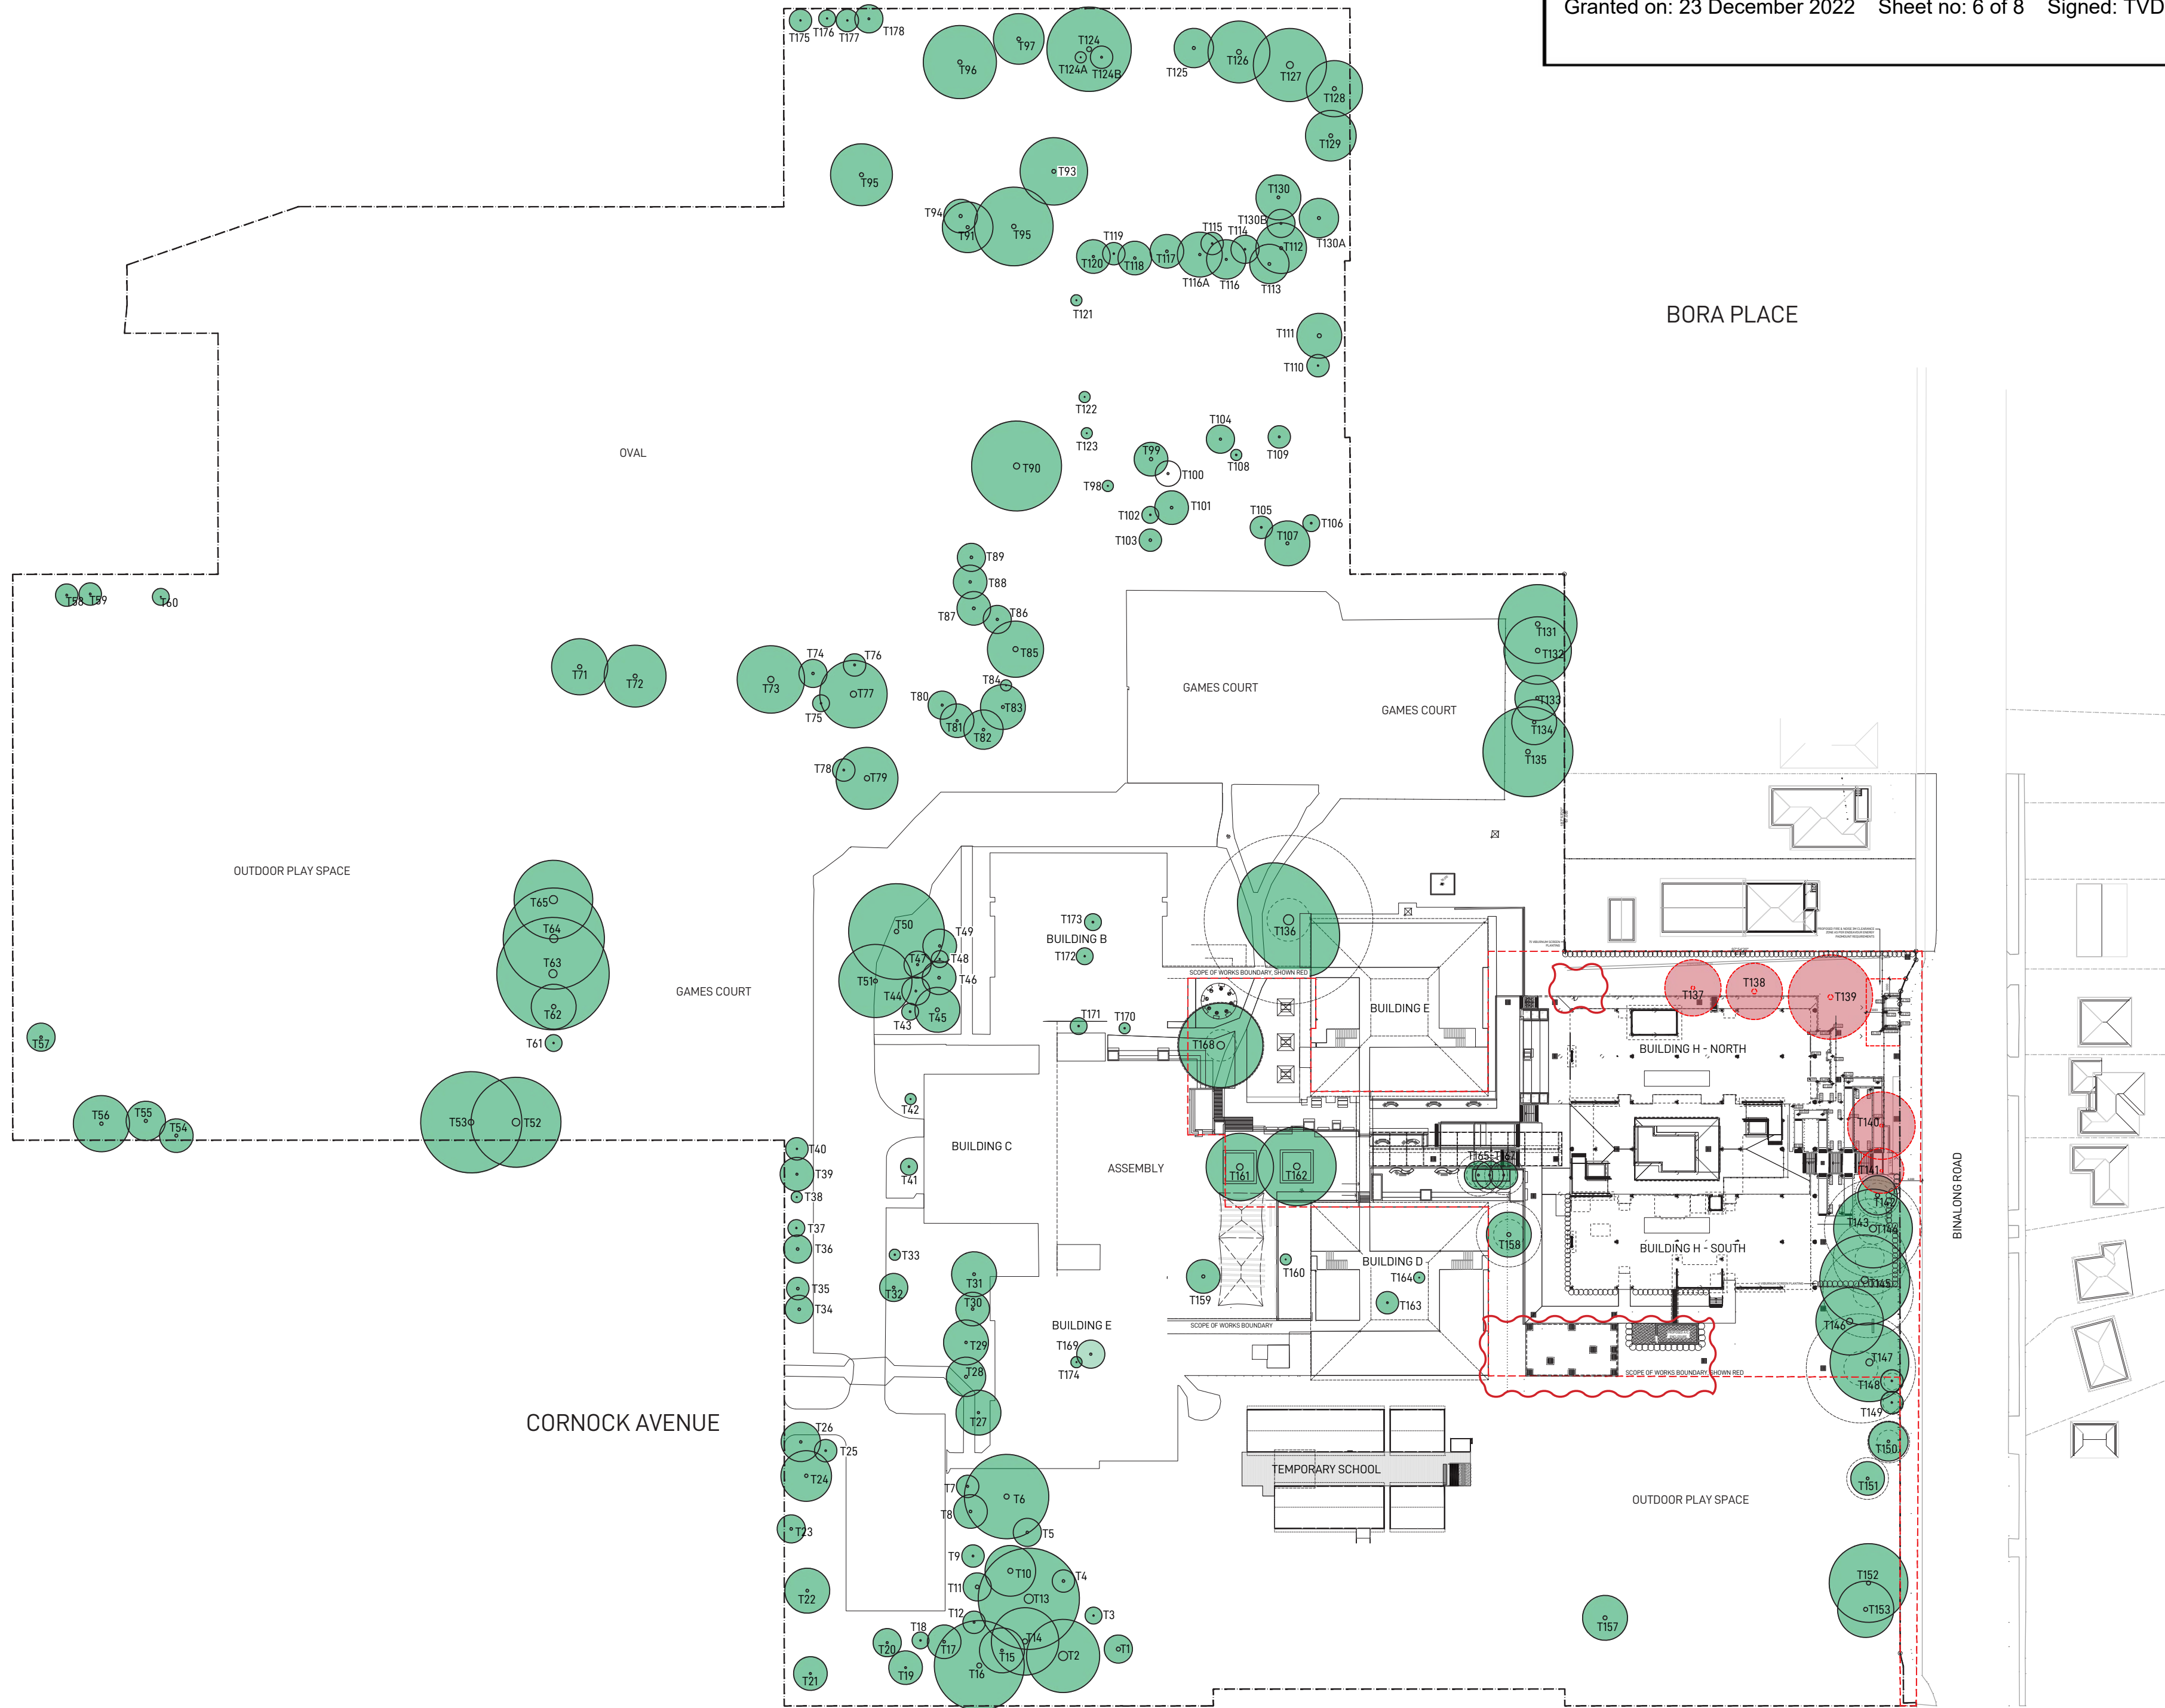

EXISTING TREE SCHEDULE

Tree	Description	Existing Height	Proposed Action
1	Lophostemon confertus (Brush Box)	11m	Retain
2	Eucalyptus saligna (Sydney Blue Gum)	21m	Retain
3	Eucalyptus elata (River Peppermint)	5m	Retain
4	Allocasuarina torulosa (Rose She-Oak)	10m	Retain
5	Allocasuarina torulosa (Rose She-Oak)	6m	Retain
6	Eucalyptus scoparia (Wallangarra White Gum)	17m	Retain
7	Eucalyptus scoparia (Wallangarra White Gum)	8m	Retain
8	Liquidambar styraciflua (Liquidambar)	7m	Retain
9	Allocasuarina torulosa (Rose She-Oak)	7m	Retain
10	Angophora costata (Smooth-barked Apple)	10m	Retain
11	Allocasuarina torulosa (Rose She-Oak)	10m	Retain
12	Allocasuarina torulosa (Rose She-Oak)	8m	Retain
13	Eucalyptus saligna (Sydney Blue Gum)	20m	Retain
14	Eucalyptus tereticornis (Forest Red Gum)	22m	Retain
15	Eucalyptus tereticornis (Forest Red Gum)	21m	Retain
16	Eucalyptus saligna (Sydney Blue Gum)	18m	Retain
17	Callistemon salignus (Willow Bottlebrush)	19m	Retain
18	Allocasuarina torulosa (Rose She-Oak)	7m	Retain
19	Eucalyptus crebra (Narrow-leaved Ironbark)	13m	Retain
20	Allocasuarina torulosa (Rose She-Oak)	10m	Retain
21	Allocasuarina torulosa (Rose She-Oak)	11m	Retain
22	Eucalyptus tereticornis (Forest Red Gum)	18m	Retain
23	Unknown species	9m	Retain
24	Olea europaea (European Olive)	8m	Retain
25	Callistemon salignus (Willow Bottlebrush)	7m	Retain
26	Cedrus deodara (Deodar Cedar)	15m	Retain
27	Jacaranda mimosifolia (Blue Jacaranda)	9m	Retain
28	Jacaranda mimosifolia (Blue Jacaranda)	10m	Retain
29	Jacaranda mimosifolia (Blue Jacaranda)	11m	Retain
30	Jacaranda mimosifolia (Blue Jacaranda)	11m	Retain
31	Jacaranda mimosifolia (Blue Jacaranda)	12m	Retain
32	Hibiscus spp. (Hibiscus)	5m	Retain
33	Callistemon viminalis (Weeping Bottlebrush)	3m	Retain
34	Leptospermum petersonii (Lemon-scented Tea Tree)	6m	Retain
35	Leptospermum petersonii (Lemon-scented Tea Tree)	5m	Retain
36	Leptospermum petersonii (Lemon-scented Tea Tree)	5m	Retain
37	Leptospermum petersonii (Lemon-scented Tea Tree)	5m	Retain
38	Leptospermum petersonii (Lemon-scented Tea Tree)	4m	Retain
39	Leptospermum petersonii (Lemon-scented Tea Tree)	6m	Retain
40	Leptospermum petersonii (Lemon-scented Tea Tree)	6m	Retain
41	Plumeria spp. (Frangipani)	2-3m	Retain
42	Plumeria spp. (Frangipani)	1-2m	Retain
43	Elaeocarpus reticulatus (Blueberry Ash)	7m	Retain
44	Elaeocarpus reticulatus (Blueberry Ash)	8m	Retain
45	Grevillea robusta (Silky Oak)	17m	Retain
46	Brachychiton acerifolius (Illawarra Flame Tree)	11m	Retain
47	Unknown species	8m	Retain
48	Stenocarpus sinuatus (Firewheel Tree)	8m	Retain
49	Grevillea robusta (Silky Oak)	19m	Retain
50	Corymbia maculata (Spotted Gum)	17m	Retain
51	Corymbia citriodora (Lemon-scented Gum)	18m	Retain
52	Corymbia maculata (Spotted Gum)	26m	Retain
53	Corymbia maculata (Spotted Gum)	27m	Retain
54	Ligustrum spp. (Privet)	9m	Retain
55	Jacaranda mimosifolia (Blue Jacaranda)	10m	Retain
56	Eucalyptus crebra (Narrow-leaved Ironbark)	16m	Retain
57	Melaleuca quinquenervia (Broad-leaved Paperbark)	6m	Retain
58	Melaleuca quinquenervia (Broad-leaved Paperbark)	7m	Retain
59	Melaleuca quinquenervia (Broad-leaved Paperbark)	7m	Retain
60	Melaleuca quinquenervia (Broad-leaved Paperbark)	5m	Retain
61	Eucalyptus microcarpa (Grey Box)	5m	Retain
62	Eucalyptus microcarpa (Grey Box)	17m	Retain
63	Eucalyptus microcarpa (Grey Box)	19m	Retain
64	Eucalyptus microcarpa (Grey Box)	17m	Retain
65	Eucalyptus microcarpa (Grey Box)	16m	Retain
66	Callistemon viminalis (Weeping Bottlebrush)	4m	Remove
67	Callistemon viminalis (Weeping Bottlebrush)	4m	Remove
68	Acacia implexa (Hickory Wattle)	11m	Remove
69	Callistemon salignus (Willow Bottlebrush)	7m	Remove
70	Callistemon salignus (Willow Bottlebrush)	6m	Remove
71	Corymbia maculata (Spotted Gum)	13m	Retain
72	Schinus molle (Peppercorn Tree)	9m	Retain
73	Schinus molle (Peppercorn Tree)	8m	Retain
74	Eucalyptus tereticornis (Forest Red Gum)	15m	Retain
75	Eucalyptus tereticornis (Forest Red Gum)	14m	Retain
76	Eucalyptus tereticornis (Forest Red Gum)	10m	Retain
77	Eucalyptus paniculata (Grey Ironbark)	15m	Retain
78	Schinus molle (Peppercorn Tree)	3m	Retain
79	Eucalyptus globulus (Tasmanian Blue Gum)	14m	Retain
80	Eucalyptus tereticornis (Forest Red Gum)	12m	Retain
81	Eucalyptus tereticornis (Forest Red Gum)	14m	Retain
82	Eucalyptus tereticornis (Forest Red Gum)	5m	Retain
83	Eucalyptus tereticornis (Forest Red Gum)	17m	Retain
84	Eucalyptus tereticornis (Forest Red Gum)	9m	Retain
85	Eucalyptus crebra (Narrow-leaved Ironbark)	12m	Retain
86	Eucalyptus tereticornis (Forest Red Gum)	12m	Retain
87	Eucalyptus tereticornis (Forest Red Gum)	14m	Retain
88	Eucalyptus tereticornis (Forest Red Gum)	12m	Retain
89	Eucalyptus tereticornis (Forest Red Gum)	19m	Retain
90	Eucalyptus resinifera (Red Mahogany)	23m	Retain
91	Eucalyptus microcarpa (Grey Box)	20m	Retain
92	Eucalyptus microcarpa (Grey Box)	21m	Retain
93	Eucalyptus microcarpa (Grey Box)	20m	Retain
94	Ficus elastica (Rubber Fig)	6m	Retain
95	Eucalyptus paniculata (Grey Ironbark)	17m	Retain
96	Eucalyptus tereticornis (Forest Red Gum)	22m	Retain
97	Eucalyptus paniculata (Grey Ironbark)	17m	Retain
98	Citrus spp (Citrus)	3m	Retain

Tree	Description	Existing Height	Proposed Action
99	Lophostemon confertus (Brush Box)	9m	Retain
100	Unknown species	7m	Retain
101	Syzygium romanzoffiana (Cocos Palm)	7m	Retain
102	Backhousia myrtifolia (Grey Myrtle)	4m	Retain
103	Backhousia myrtifolia (Grey Myrtle)	6m	Retain
104	Ailanthus altissima (Tree of Heaven)	8m	Retain
105	Plumeria spp. (Frangipani)	2m	Retain
106	Citrus spp (Citrus)	3m	Retain
107	Bamboo spp (Bamboo)	3m	Retain
108	Cupressus sempervirens (Mediterranean Cypress)	5m	Retain
109	Ligustrum spp. (Privet)	6m	Retain
110	Grevillea robusta (Silky Oak)	7m	Retain
111	Jacaranda mimosifolia (Blue Jacaranda)	8m	Retain
112	Callistemon viminalis (Weeping Bottlebrush)	11m	Retain
113	Callistemon viminalis (Weeping Bottlebrush)	8m	Retain
114	Leptospermum petersonii (Lemon-scented Tea Tree)	6m	Retain
115	Ligustrum spp. (Privet)	6m	Retain
116	Cinnamomum camphora (Camphor Laurel)	13m	Retain
116a	Melaleuca quinquenervia (Broad-leaved Paperbark)	12m	Retain
117	Morus spp (Mulberry tree)	9m	Retain
118	Hakea spp (Hakea)	7m	Retain
119	Olea europaea (European Olive)	6m	Retain
120	Ficus carica (Common Fig)	6m	Retain
121	Citrus spp (Citrus)	2m	Retain
122	Prunus spp	2m	Retain
123	Prunus spp	2m	Retain
124	Eucalyptus tereticornis (Forest Red Gum)	23m	Retain
124a	Banksia integrifolia (Coast Banksia)	5m	Retain
124b	Callistemon salignus (Willow Bottlebrush)	5m	Retain
125	Quercus robur (English Oak)	10m	Retain
126	Eucalyptus sideroxylon (Mugga Ironbark)	17m	Retain
127	Eucalyptus paniculata (Grey Ironbark)	26m	Retain
128	Eucalyptus tereticornis (Forest Red Gum)	22m	Retain
129	Eucalyptus tereticornis (Forest Red Gum)	22m	Retain
130	Morus spp (Mulberry tree)	10m	Retain
130a	Morus spp (Mulberry tree)	10m	Retain
130b	Leptospermum spp. (Tea Tree)	7m	Retain
131	Lophostemon confertus (Brush Box)	12m	Retain
132	Lophostemon confertus (Brush Box)	12m	Retain
133	Lophostemon confertus (Brush Box)	8m	Retain
134	Casuarina cunninghamiana (River She-Oak)	12m	Retain
135	Corymbia citriodora (Lemon-scented Gum)	14m	Retain
136	Ficus rubiginosa (Port Jackson Fig)	14m	Retain
137	Jacaranda mimosifolia (Blue Jacaranda)	8m	Remove
138	Jacaranda mimosifolia (Blue Jacaranda)	10m	Remove
139	Jacaranda mimosifolia (Blue Jacaranda)	12m	Remove
140	Callistemon viminalis (Weeping Bottlebrush)	8m	Remove
141	Callistemon viminalis (Weeping Bottlebrush)	6m	Remove
142	Eucalyptus tereticornis (Forest Red Gum)	15m	Retain
143	Lophostemon confertus (Brush Box)	6m	Retain
144	Corymbia maculata (Spotted Gum)	20m	Retain
145	Corymbia citriodora (Lemon-scented Gum)	20m	Retain
146	Eucalyptus tereticornis (Forest Red Gum)	13m	Retain
147	Eucalyptus tereticornis (Forest Red Gum)	14m	Retain
148	Eucalyptus spp.	5m	Retain
149	Eucalyptus spp.	4m	Retain
150	Leptospermum petersonii (Lemon-scented Tea Tree)	5m	Retain
151	Eucalyptus sideroxylon (Mugga Ironbark)	6m	Retain
152	Corymbia maculata (Spotted Gum)	10m	Retain
153	Eucalyptus rubida (Candlebark)	14m	Retain
154	Eucalyptus nicholii (Black Peppermint)	8m	Remove
155	Eucalyptus tereticornis (Forest Red Gum)	7m	Remove
156	Corymbia citriodora (Lemon-scented Gum)	14m	Remove
157	Olea europaea (European Olive)	6m	Retain
158	Grevillea robusta (Silky Oak)	18m	Retain
159	Callistemon viminalis (Weeping Bottlebrush)	7m	Retain
160	Camellia spp. (Camellia)	2m	Retain
161	Platanus x acerifolius (London Plane Tree)	14m	Retain
162	Platanus x acerifolius (London Plane Tree)	13m	Retain
163	Livistonia chinensis (Chinese Fan Palm)	9m	Retain
164	Camellia spp. (Camellia)	2m	Retain
165	Callistemon viminalis (Weeping Bottlebrush)	6m	Retain
166	Callistemon viminalis (Weeping Bottlebrush)	6m	Retain
167	Callistemon viminalis (Weeping Bottlebrush)	6m	Retain
168	Jacaranda mimosifolia (Blue Jacaranda)	-	Retain
169	Prunus spp	3m	Retain
170	Camellia spp. (Camellia)	3m	Retain
171	Camellia spp. (Camellia)	4m	Retain
172	Brachychiton acerifolius (Illawarra Flame Tree)	10m	Retain
173	Camellia spp. (Camellia)	5m	Retain
174	Prunus spp	2m	Retain
175	Cupaniopsis anacardioides (Tuckeroo)	6m	Retain
176	Lophostemon confertus (Brush Box)	6m	Retain
177	Cupaniopsis anacardioides (Tuckeroo)	6m	Retain
178	Casuarina cunninghamiana (River She-Oak)	8m	Retain



Department of Planning
and Environment

Issued under the *Environmental Planning and Assessment Act 1979*

Approve Section: 4.55(1A) Application No: SSD-9579147-Mod-1

Granted on: 23 December 2022 Sheet no: 7 of 8 Signed: TVD

LEGEND


SITE BOUNDARY

SCOPE OF WORKS BOUNDARY

EXISTING TREES TO BE RETAINED

PROPOSED TREES

NOTE: PROPOSED CANOPY PLAN SUBJECT TO CHANGE
FOLLOWING INDIGENOUS CONSULTATION

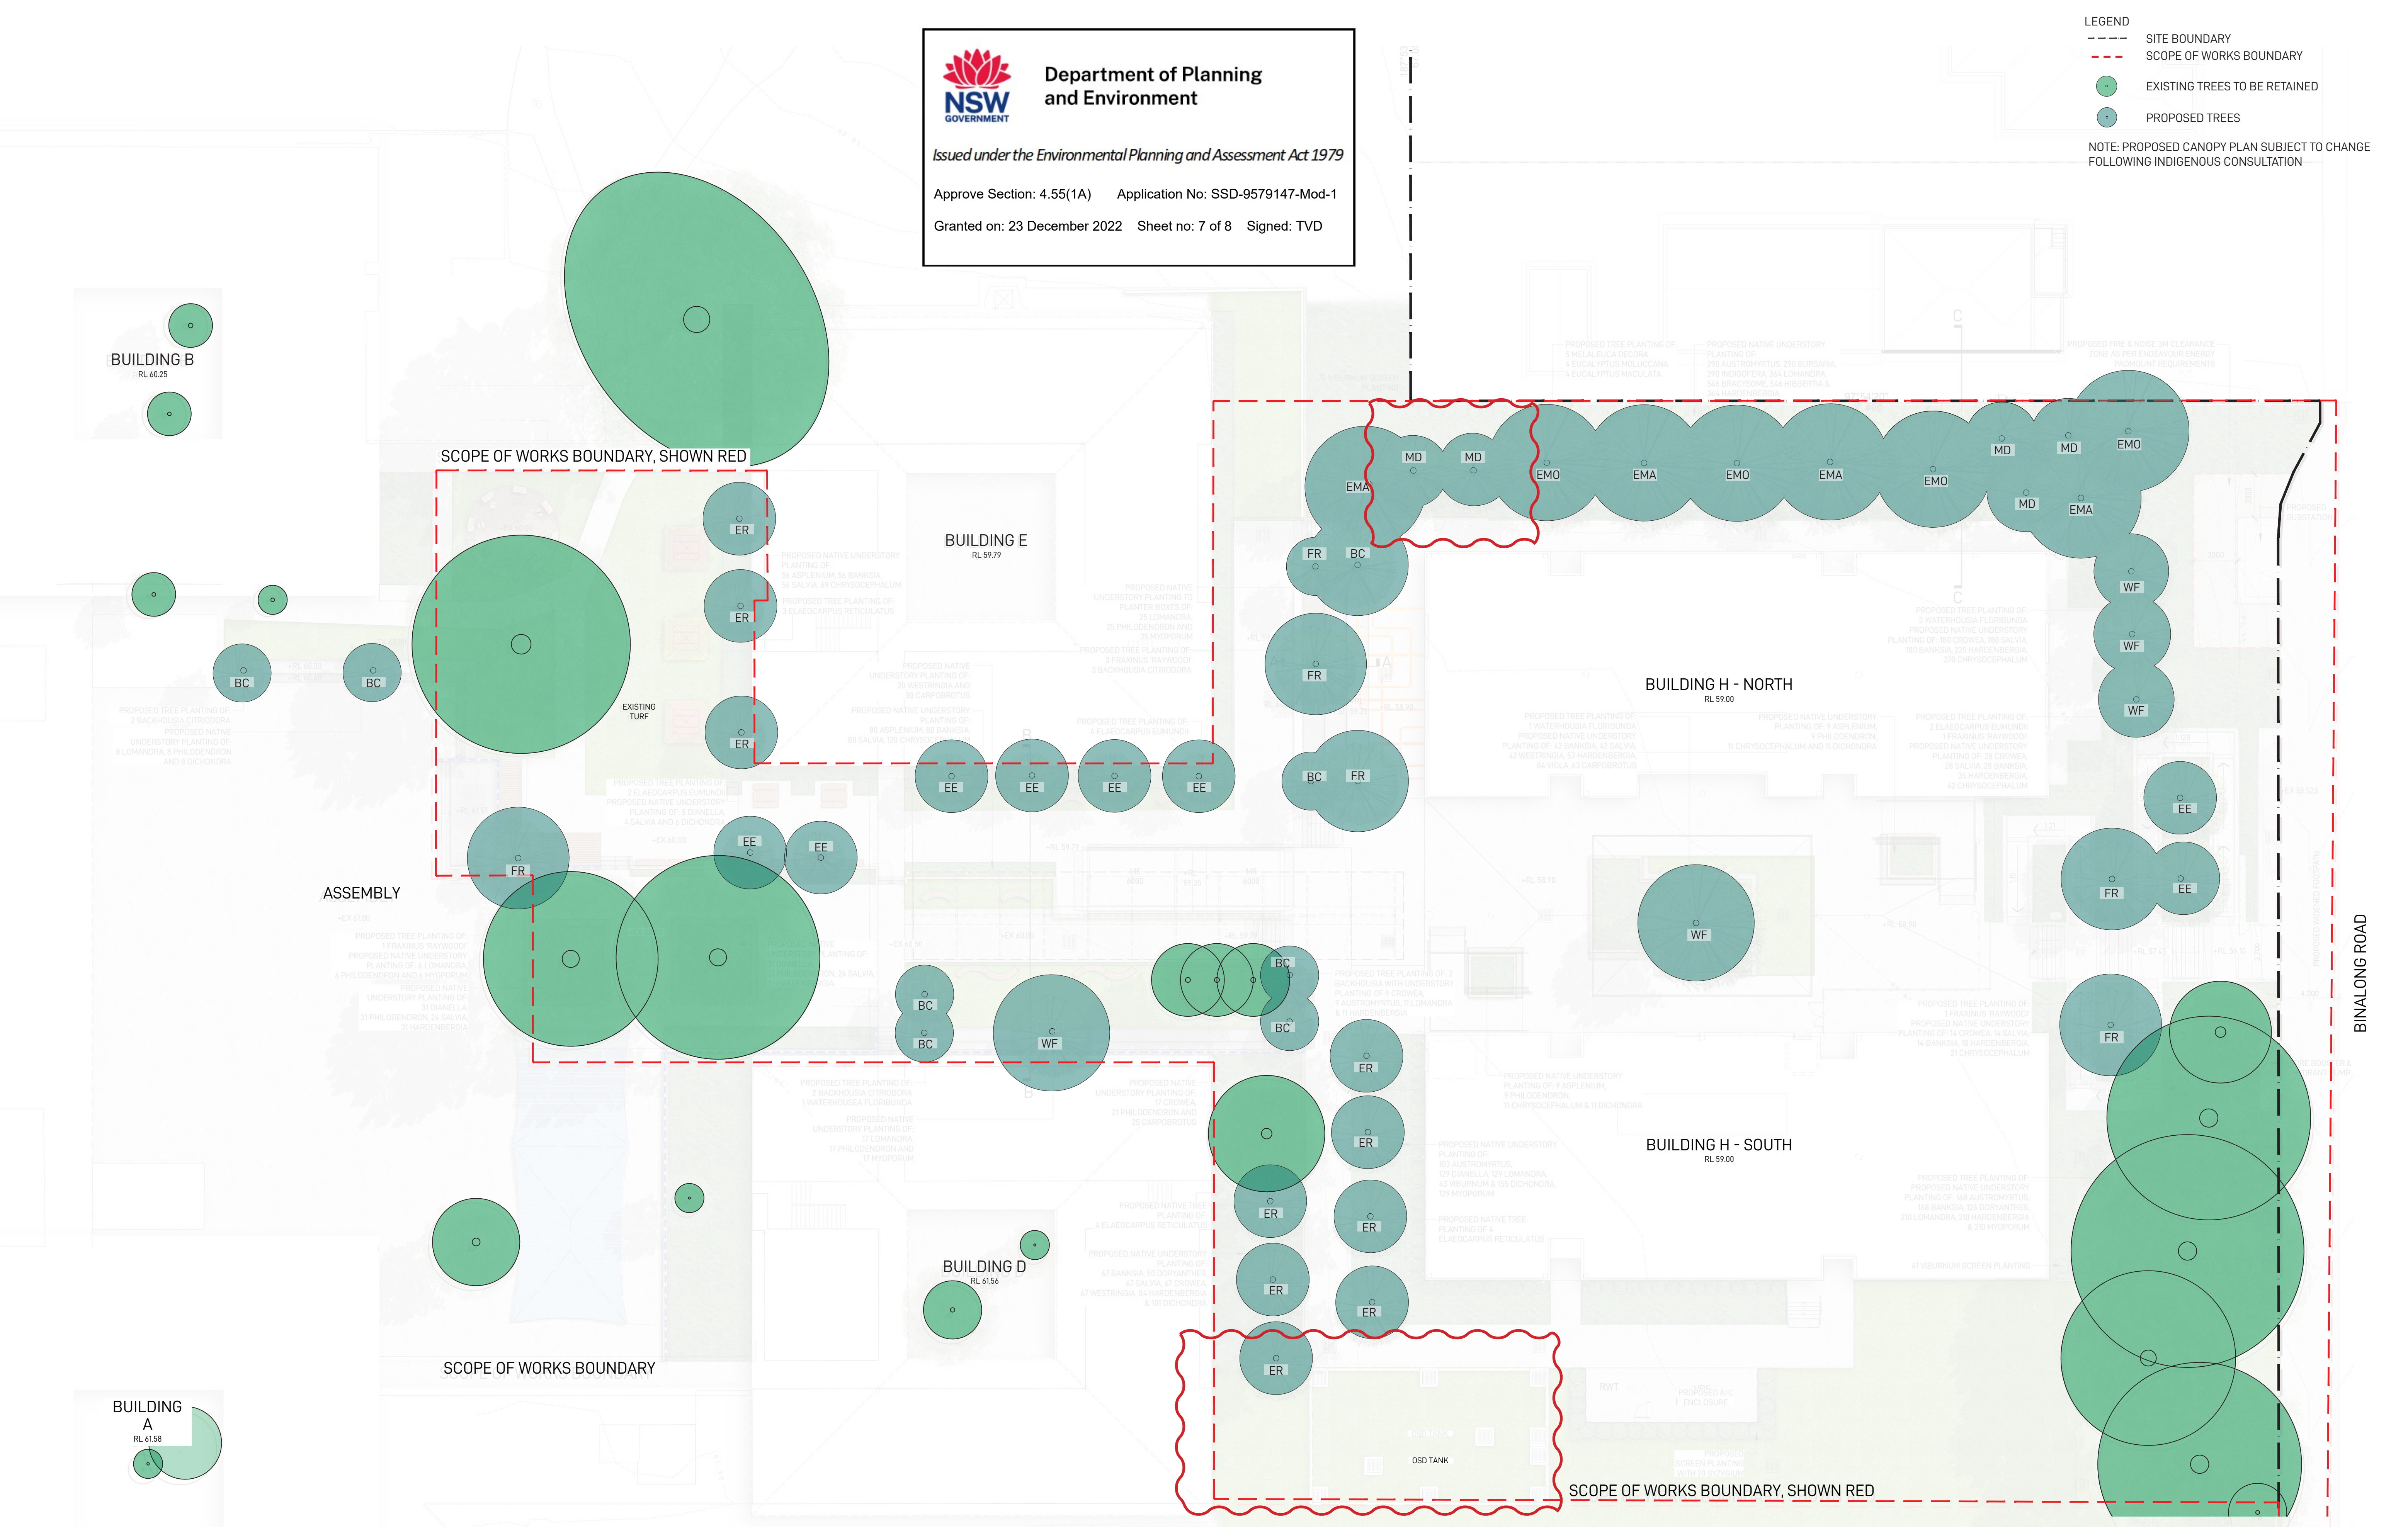

LANDSCAPE ARCHITECT



SUITE 201, 75 ARCHER ST, CHATSWOOD NSW 2067 PH. (02) 9411 3279
WWW.GROUNDINK.COM.AU ABN 55 163 025 456 ACN 163 025 456
© GROUND INK PTY LTD THIS DESIGN AND DRAWING IS PROTECTED BY COPYRIGHT.

CLIENT



Education

ARCHITECT

FULTON TROTTER ARCHITECTS
LEVEL 3/35 SPRING ST, BONDI JUNCTION
NSW 2022 PH. (02) 8383 5151
WWW.FULTONTROTTER.COM.AU/

ENGINEER

AURECON GROUP
5/116 MILITARY RD, NEUTRAL BAY NSW
2089 PH. (02) 9465 5599
HTTPS://WWW.AURECONGROUP.COM/

NOTE

VERIFY ALL DIMENSIONS ON SITE BEFORE COMMENCING WORK.
REPORT ALL DISCREPANCIES TO LANDSCAPE ARCHITECT PRIOR TO
CONSTRUCTION. FIGURED DIMENSIONS TO BE TAKEN IN PREFERENCE
TO SCALED DRAWINGS. ALL WORK IS TO CONFORM TO RELEVANT
AUSTRALIAN STANDARDS AND OTHER CODES AS APPLICABLE. LOCATION
OF UNDERGROUND SERVICES TO BE PROVEN ON SITE AND PROTECTED
IF NECESSARY PRIOR TO CONSTRUCTION. DIAL BEFORE YOU DIG. PLANT
SPECIES AND QUANTITIES SHOWN ARE INDICATIVE ONLY AND ARE SUBJECT
TO CHANGE BASED ON FUTURE PROJECT REQUIREMENTS.

ISSUE	DATE	DESCRIPTION	DRAWN	CHECKED
C	30.03.21	FOR DA	ML	RL
D	30.04.21	ISSUE FOR SD	ML	RL
E	04.05.21	ISSUE FOR SSDA	ML	RL
F	25.06.21	ISSUE FOR SSDA	ML	RL
G	29.06.21	ISSUE FOR SSDA	ML	RL
H	16.07.21	ISSUE FOR SSDA	ML	RL
I	27.09.22	ISSUE FOR S4.55	ML	RL
J	07.11.22	ISSUE FOR S4.55	ML	RL

DRAWING TITLE

CANOPY COVERAGE PLAN

DATE	JOB NUMBER	DRAWN	CHECKED	DRAWING NUMBER
07-Nov-2022	20200902	ML	RL	LDA-002

PROJECT

PENDLE HILL HIGH SCHOOL
PENDLE HILL NSW 2145

SCALE 1:200 @ A1

0 25 50 75 100m

REVISION

J

