


1 Carrington Park - Car Park
1:100

Wayfinding, Heritage & Welcome to Country Sign.

P3 Cove finish concrete with control and expansion jointing to Civil Engineer's detail



Rev	Amendment	Date	By
1	As Built Issue	11/08/23	CD

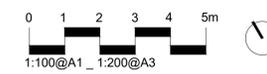

IMPORTANT NOTES:
 Do not scale drawings.
 Large scale drawings and other dimensions take precedence. All dimensions in mm unless otherwise stated.
 All dimensions and fixings to be verified.
 All fixings to be verified.
 Verify all dimensions on site before the commencement of any work.
 Confirm any and all details and finishes at service prior to construction.
 All work shall be carried out in accordance with AS, BCA and Local Government Regulations.
 Check and confirm all details and finishes with the relevant authority.
 All work shall be carried out in a professional manner by Qualified Tradesmen according to Landscape Drawings and Engineer's Specifications.

CLIENT SINSW	CHECKED MB
ARCHITECT Hayball	DRAWN CD
SCALE 1:100 @ A1	SIZE A1
	STAGE AS BUILT

DWG. TITLE
Carrington Car Park

PROJECT
Young High School and Hilltops Council Library & Community Facility

AS BUILT

AB-C01